


30401 Agoura Road // Suite 260 // ±7,206 RSF

Available 6/1/2021

As Built

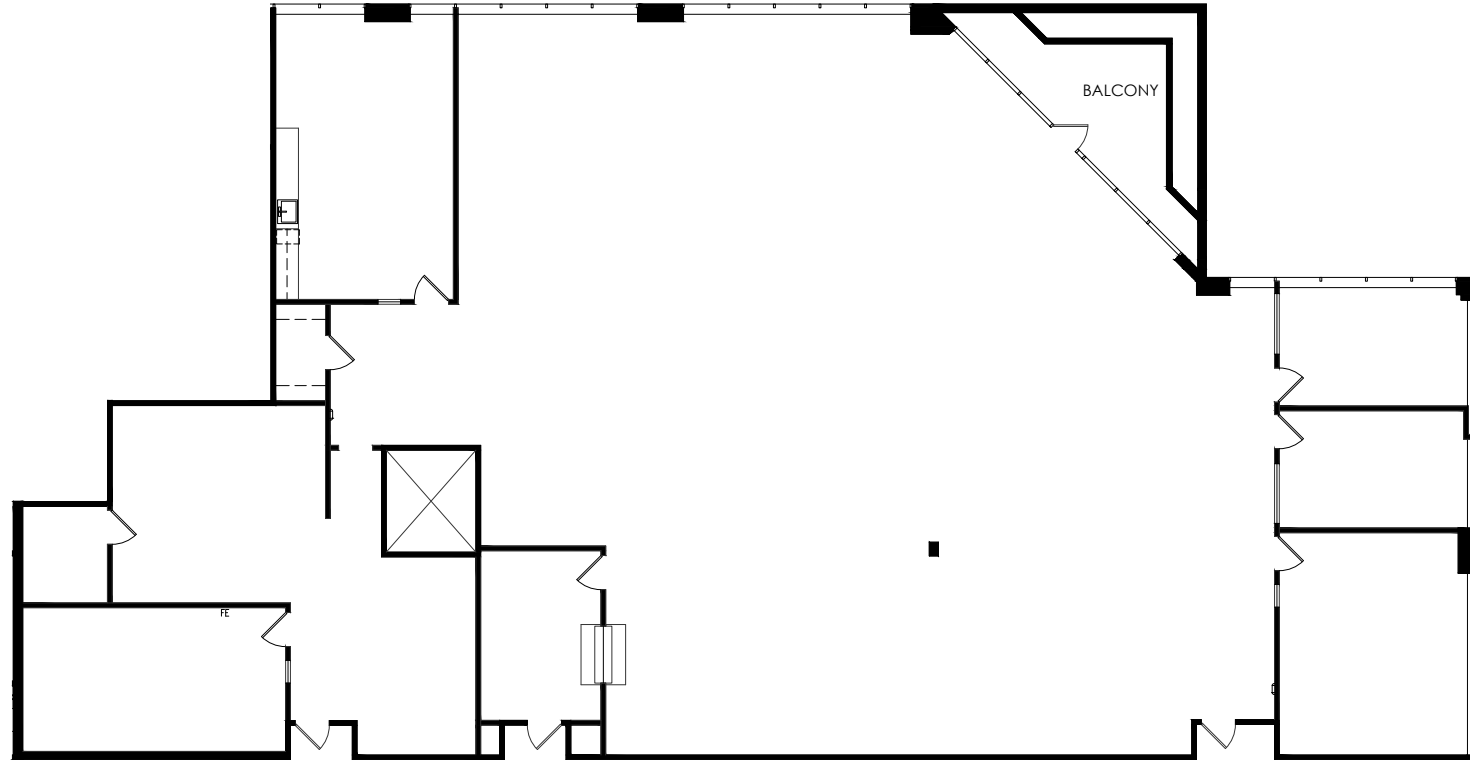

Virtual Tour

